



ARCHITECTURE \ INTERIORS \ ENGINEERING

KKT ARCHITECTS, INC.

2200 SOUTH UTICA PLACE, SUITE 200

TULSA, OKLAHOMA 74114


[P] 918.744.4270 \ [F] 918.744.7849

WWW.KKTARCHITECTS.COM

C O F A # 534 6 / 30 / 23

6218 S. LEWIS


SUITE
106

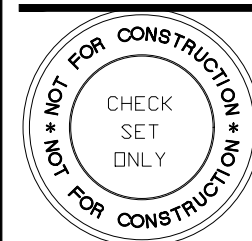

2.28.23

AS-BUILT
PLAN

AS.1

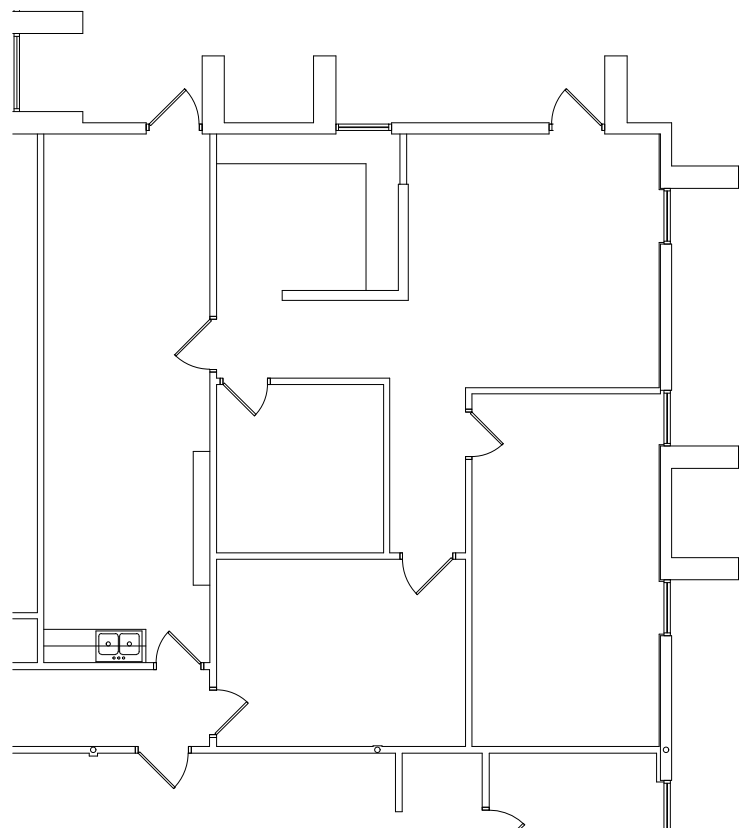


A FLOOR PLAN

SCALE: N.T.S.



NORTH

1317.98 USF
1515.68 RSF

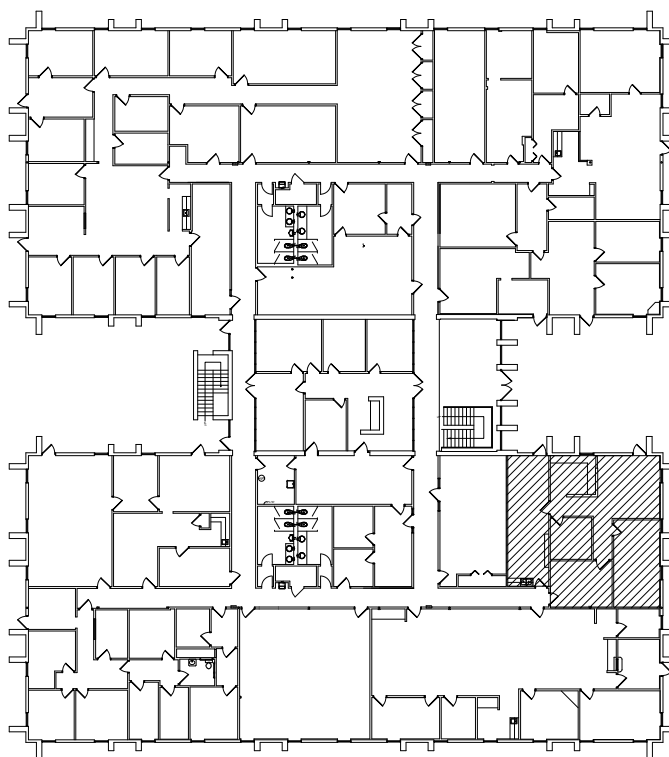

B KEY PLAN

SCALE: N.T.S.



NORTH