



ARCHITECTURE \ INTERIORS \ ENGINEERING

KKT ARCHITECTS, INC.

2200 SOUTH UTICA PLACE, SUITE 200

TULSA, OKLAHOMA 74114


[P] 918.744.4270 \ [F] 918.744.7849

WWW.KKTARCHITECTS.COM

C O F A # 5 3 4 6 / 3 0 / 2 3

6218 S. LEWIS

SUITE
125

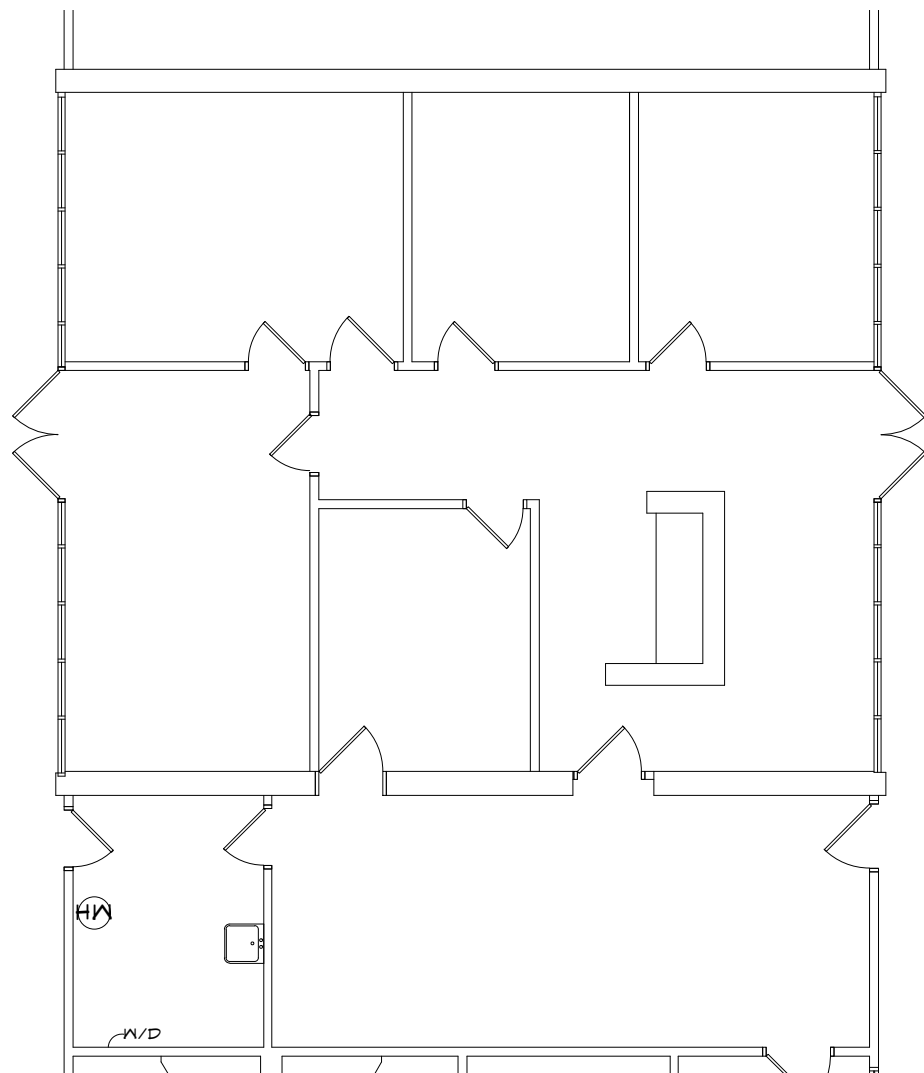


A FLOOR PLAN

SCALE: N.T.S.



1714.84 USF

1972.07 RSF

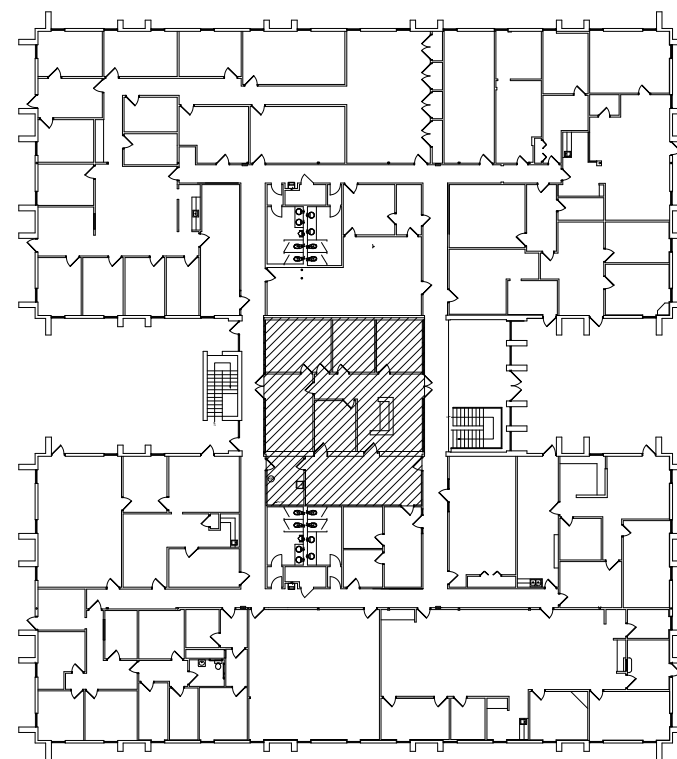


B KEY PLAN

SCALE: N.T.S.



NORTH

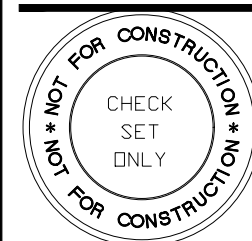

2.28.23

AS-BUILT
PLAN

AS.1