

SUITE 200


A FLOOR PLAN

SCALE: N.T.S.



NORTH

SUITE 200
3210.62 USF
3692.21 RSF

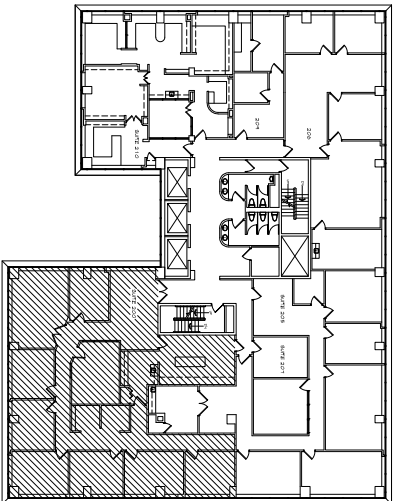

B KEY PLAN

SCALE: N.T.S.



NORTH



ARCHITECTURE \ INTERIORS \ ENGINEERING

KKT ARCHITECTS, INC.
2200 SOUTH UNICA PLACE, SUITE 200
TULSA, OKLAHOMA 74114
[P] 918.744.4270 \ [F] 918.744.7849
WWW.KKTARCHITECTS.COM
C / O F A # 534 6 / 30 / 23

**SUITE
200**

**PARK
TOWERS
2ND FLOOR**

**CASE &
ASSOCIATES**

08.15.2016

AS-BUILT
PLAN

AS.2