




ARCHITECTURE \ INTERIORS \ ENGINEERING

KKT ARCHITECTS, INC.

2200 SOUTH UTICA PLACE, SUITE 200
TULSA, OKLAHOMA 74114
[P] 918.744.4270 \ [F] 918.744.7849
WWW.KKTARCHITECTS.COM
C O F A # 534 6/30/23

**6218
S. LEWIS**

SUITE
100

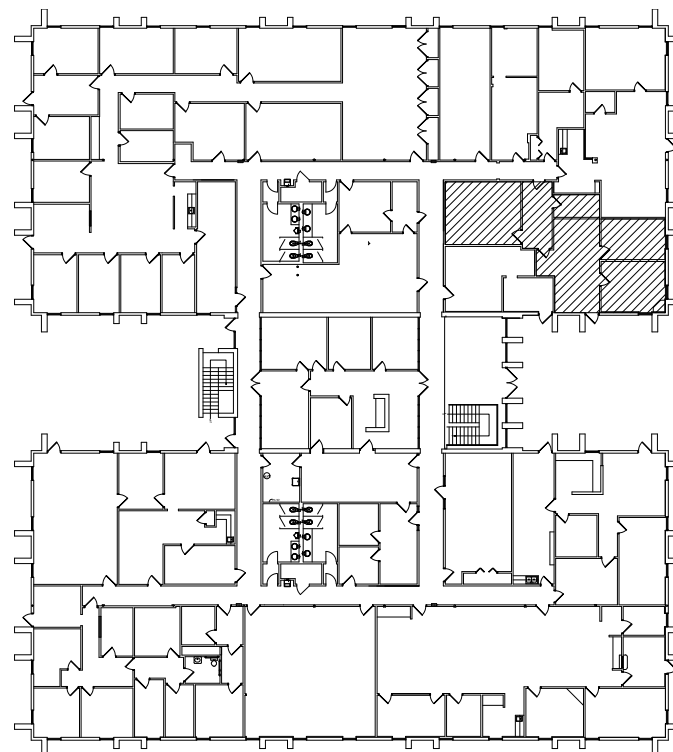


B KEY PLAN

SCALE: N.T.S.



NORTH

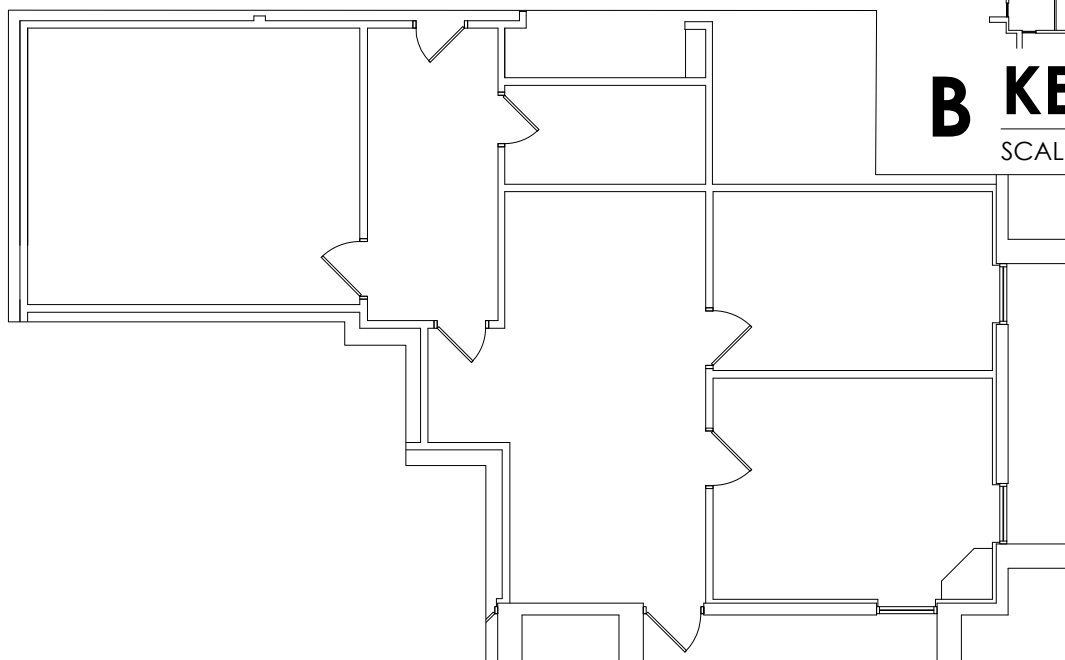


A FLOOR PLAN

SCALE: N.T.S.



NORTH

1128.19 USF
1297.42 RSF

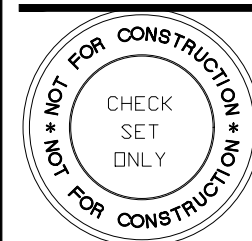

2.28.23

AS-BUILT
PLAN

AS.1