



ARCHITECTURE \ INTERIORS \ ENGINEERING


KKT ARCHITECTS, INC.
2200 SOUTH UNICA PLACE, SUITE 200
TULSA, OKLAHOMA 74114
[P] 918.744.4270 \ [F] 918.744.7849
WWW.KKTARCHITECTS.COM
C O F A # 534 6730719

**3168 SOUTH
108TH EAST
AVE. BLDG. III
SUITE 320**

FREEPORT
TRADE
CENTER

CASE
& ASSOCIATES

.....	N.T.S.
.....	TCB3P/PAS
.....	CH
.....	12/12/17

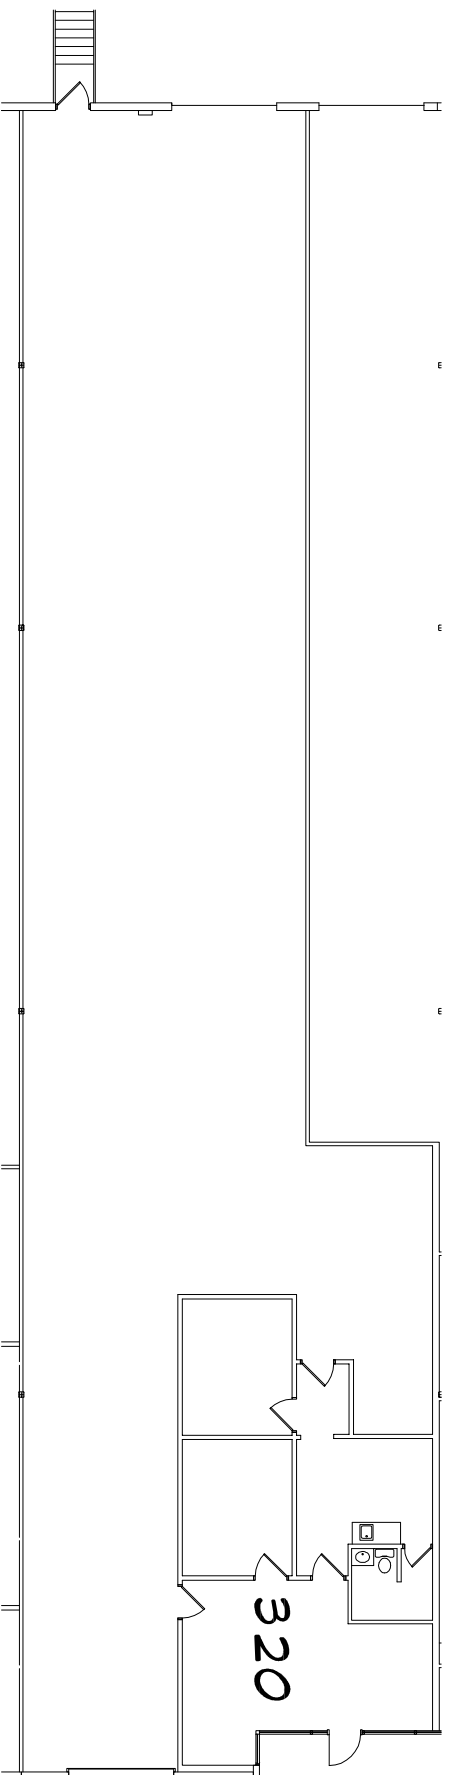

SUITE 320
OFFICE - 975.02 USF
WAREHOUSE - 4,111.76 USF
TOTAL - 5,086.78 USF

A FLOOR PLAN

SCALE: N.T.S.



NORTH

AS-BUILT
PLAN
AS-1