



FILE: X:\Drawing Files\interiors\Southern Hills Tower\asbuilt\Current As-built Southern Hills Tower\SHTO3.as.dwg PRINTED 3/3/2020 6:02:54 PM BY Everett Steele

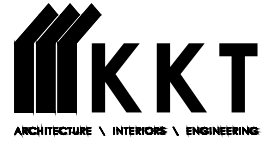

**KKT ARCHITECTS, INC.**  
2200 SOUTH UTICA PLACE, SUITE 200  
TULSA, OKLAHOMA 74114  
[P] 918.744.4270 \ [F] 918.744.7849  
WWW.KKTARCHITECTS.COM  
C O F A # 534 6/30/25

# SUITE 312


SOUTHERN HILLS  
TOWER  
2431 E 61ST  
3RD FLOOR

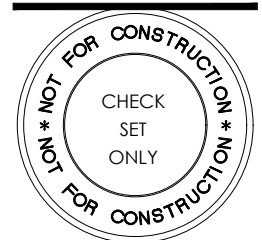

06.14.16

AS-BUILT  
PLAN

# AS.3

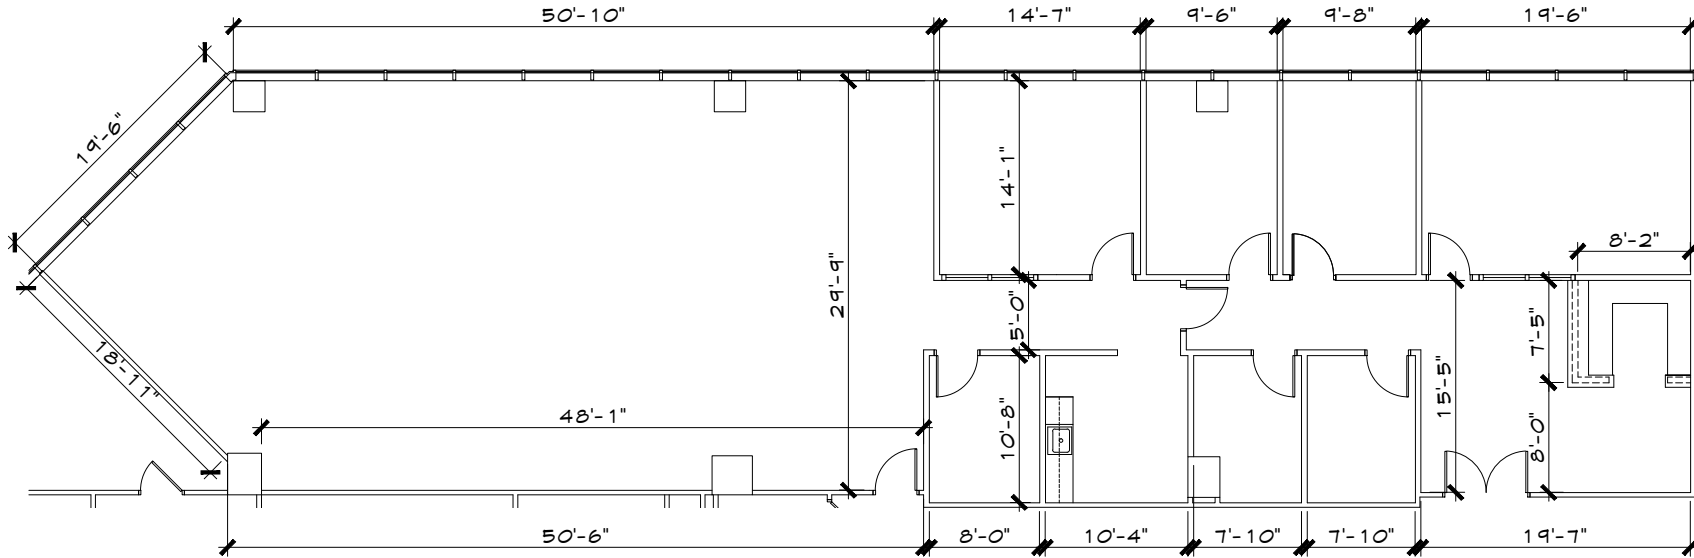

SUITE 312  
ACCOUNTING  
PRINCIPALS  
3940 RSF

# A FLOOR PLAN

SCALE: 3/16" = 1'-0"



NORTH