




ARCHITECTURE \ INTERIORS \ ENGINEERING

**KKT ARCHITECTS, INC.**

2200 SOUTH UTICA PLACE, SUITE 200  
TULSA, OKLAHOMA 74114  
[P] 918.744.4270 \ [F] 918.744.7849  
WWW.KKTARCHITECTS.COM  
C O F A # 534 6 / 30 / 23

# 6218 S. LEWIS


SUITE  
115

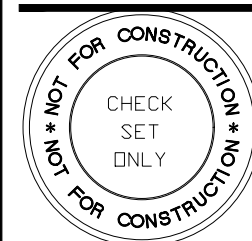

2.28.23

AS-BUILT  
PLAN

# AS.1

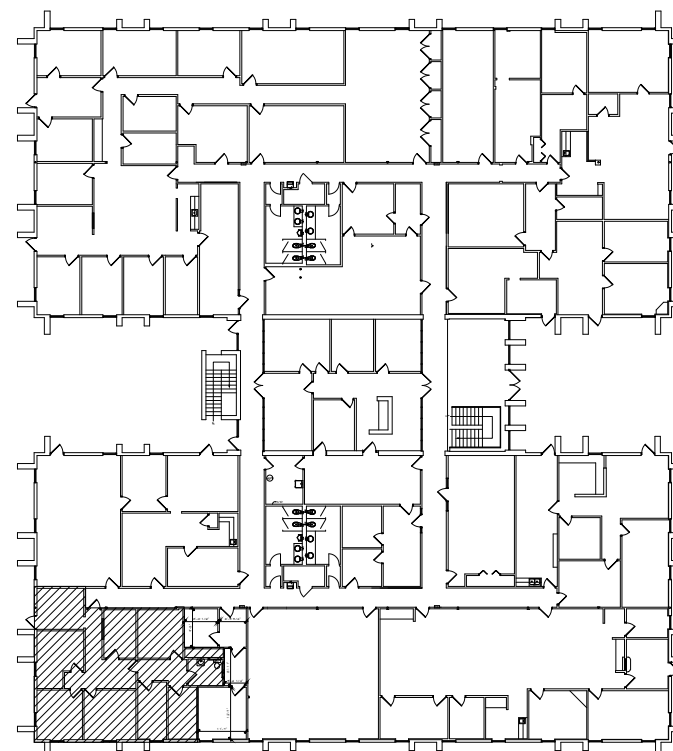


## B KEY PLAN

SCALE: N.T.S.



NORTH

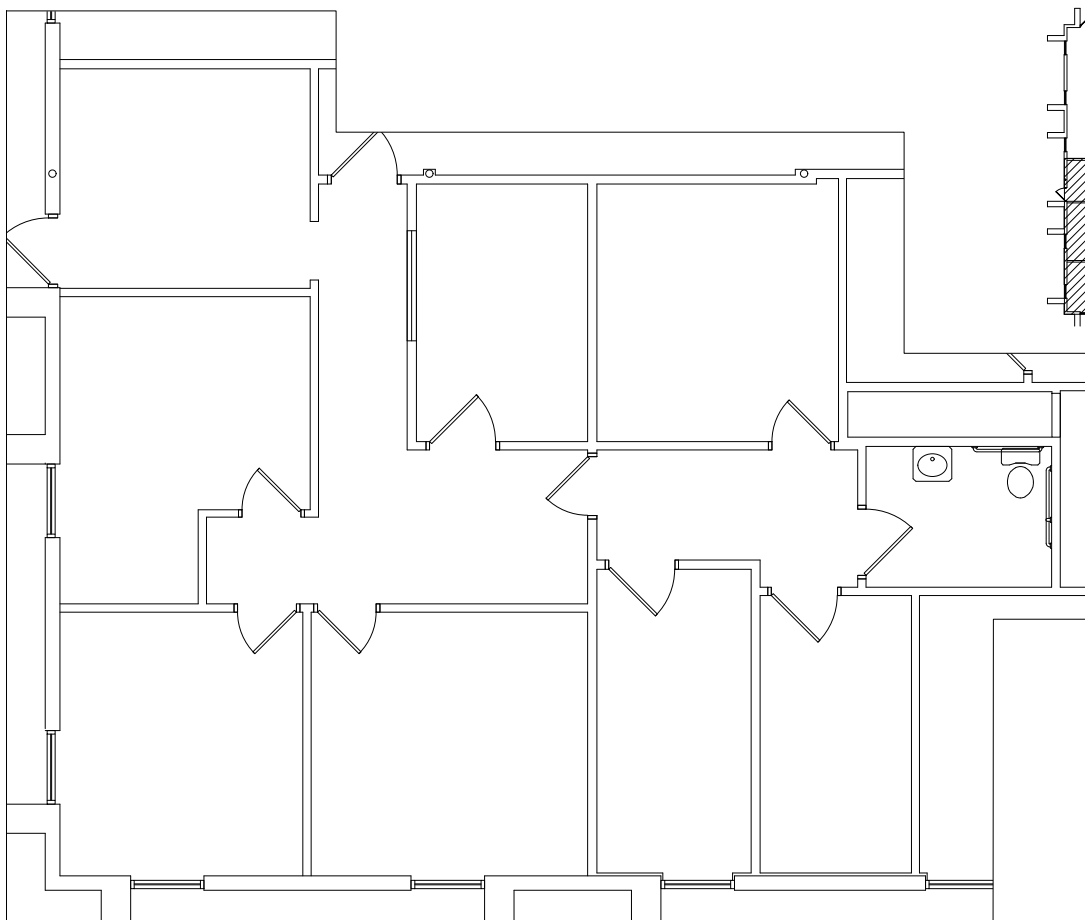

## A FLOOR PLAN

SCALE: N.T.S.



NORTH

1316.16 USF  
1513.58 RSF