


**6218
 S. LEWIS**


SUITE
 117

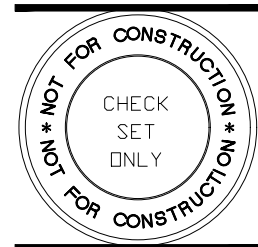

2.28.23


AS-BUILT
 PLAN

 AS.1



A FLOOR PLAN 
 SCALE: N.T.S. NORTH

1031.28 USF
 1185.97 RSF

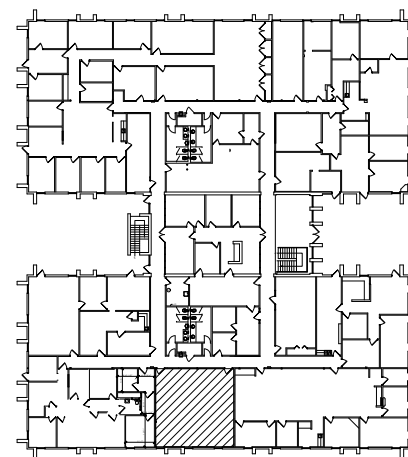

B KEY PLAN 
 SCALE: N.T.S. NORTH