



SUITE 315

SOUTHERN HILLS
TOWER
2431 EAST 61ST
3RD FLOOR
CASE &
ASSOCIATES

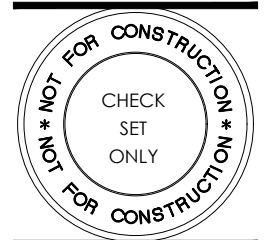

06-14-2016

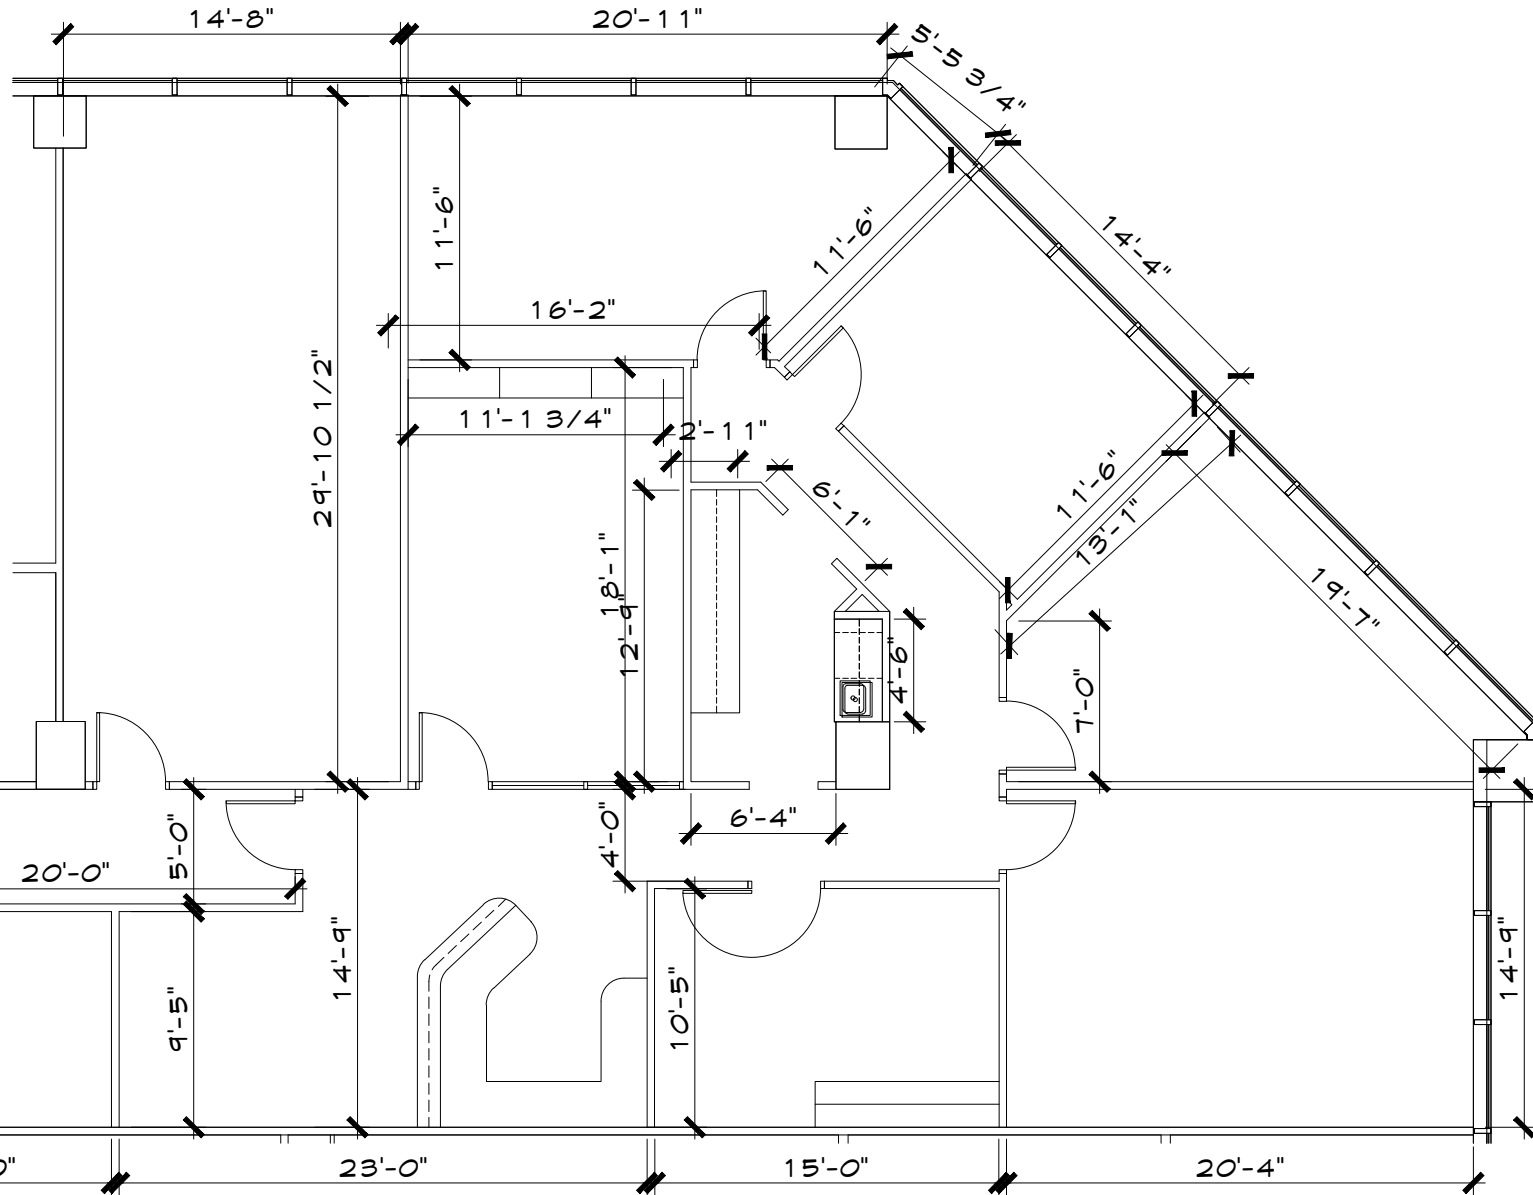

A FLOOR PLAN

SCALE: 3/16" = 1'-0"  NORTH

SUITE 315
BRIDGECREEK
INVESTMENT
MANAGEMENT, LLC
2259 RSF

AS-BUILT
PLAN
AS.3