


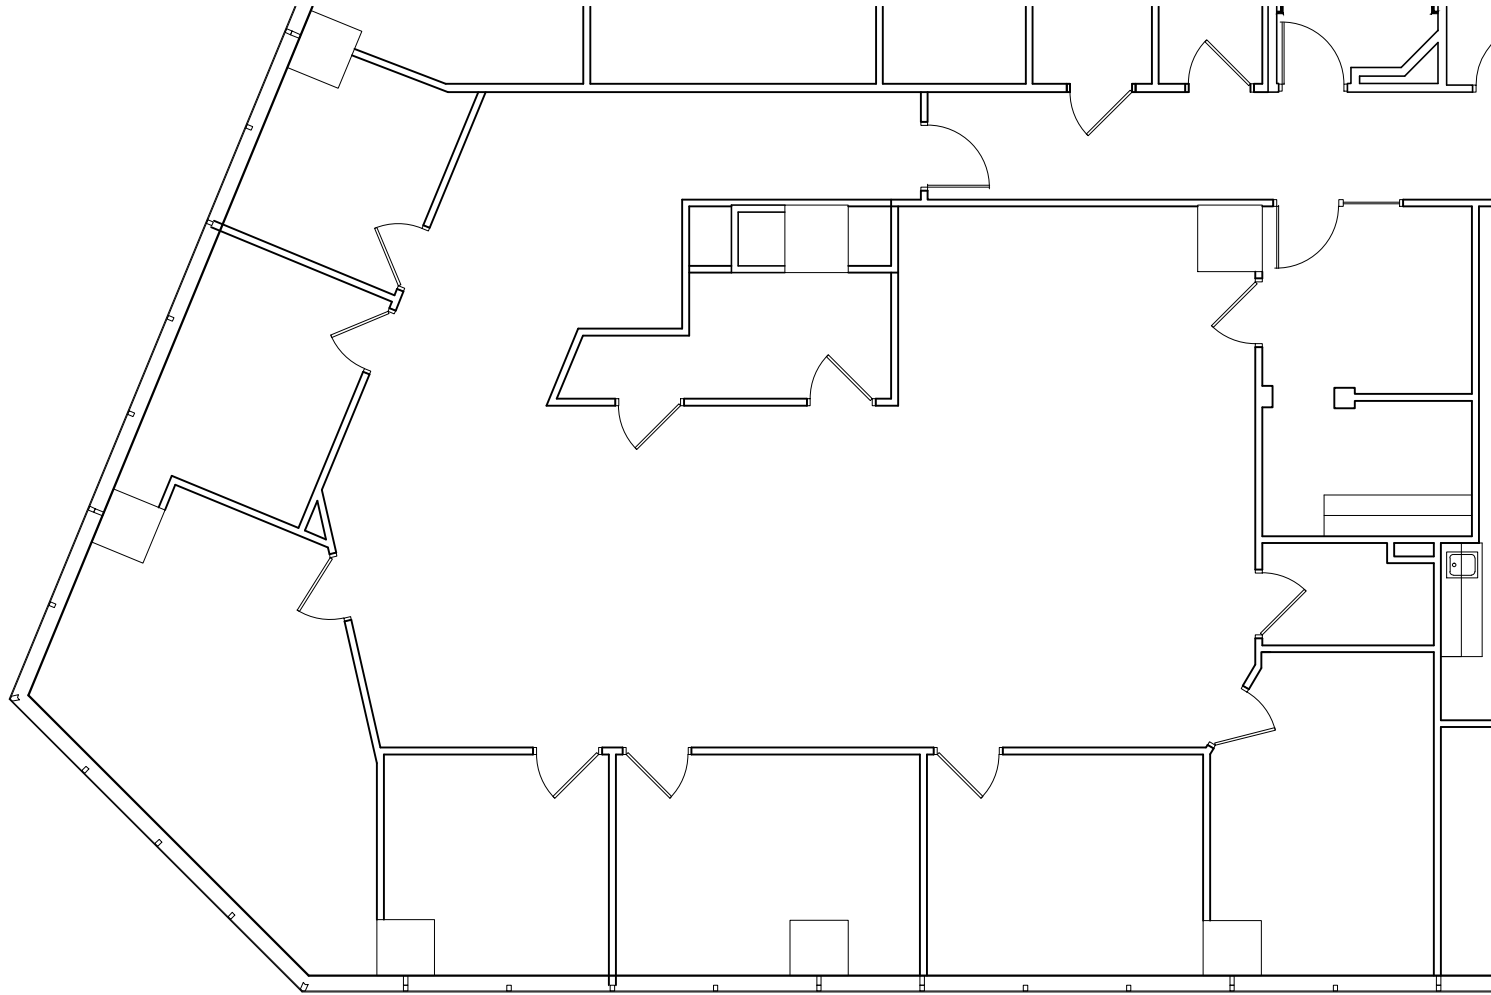


A FLOOR PLAN

SCALE: N.T.S.



NORTH

SUITE 520
3036 RSF

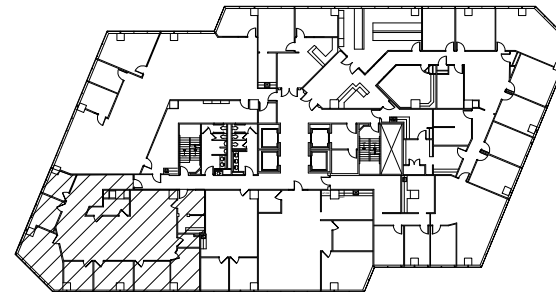

B KEY PLAN

SCALE: N.T.S.



NORTH




KKT ARCHITECTS, INC.
2200 SOUTH UTICA PLACE, SUITE 200
TULSA, OKLAHOMA 74114
[P] 918.744.4270 \ [F] 918.744.7849
WWW.KKTARCHITECTS.COM
C O F A # 534 6/30/25

**SUITE
520**

RICHMOND
PLAZA
5TH FLOOR

CASE &
ASSOCIATES

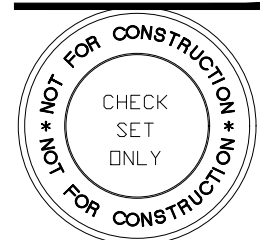

08.17.2015

AS-BUILT
PLAN

AS.5