




kinslow, keith & todd, inc.
architecture | interiors | engineering

tel 918.744.4270
fax 918.744.7849

2200 south ulica place, suite 200
tulsa, oklahoma 74114

www.kktarchitects.com

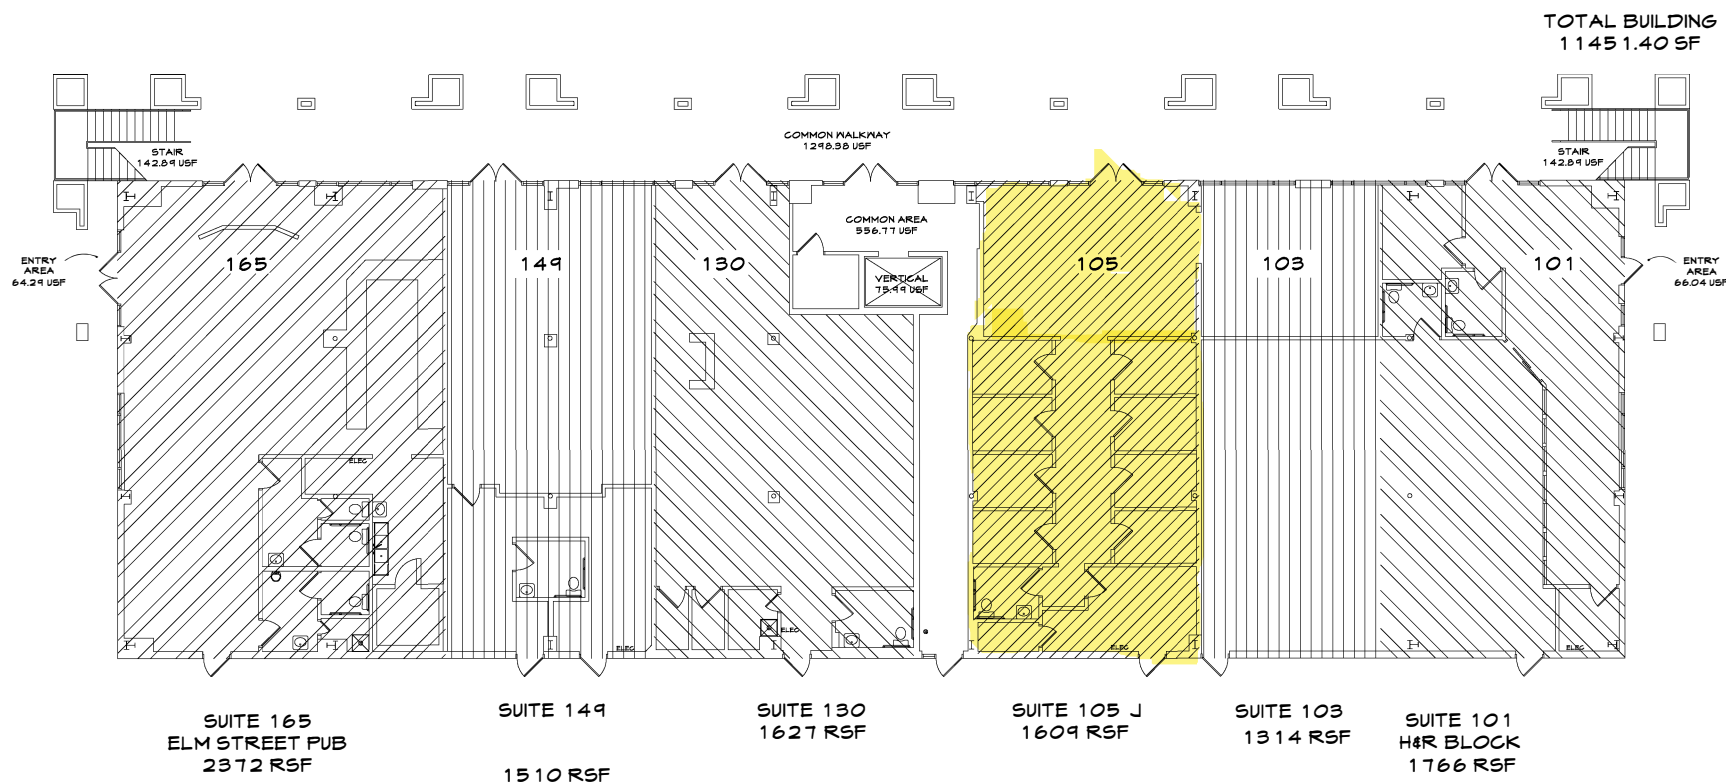

ELM STREET MARKET

329 SOUTH
ELM STREET
JENKS, OK
1ST FLOOR

SCALE	N.T.S.
FILE NAME	
MANAGER	YW
DRAWN BY	CH
	ELS
07.31.14	

A FLOOR PLAN

SCALE: N.T.S.



NORTH

AS-BUILT
PLAN

AS-1