




ARCHITECTURE \ INTERIORS \ ENGINEERING

KKT ARCHITECTS, INC.

2200 SOUTH UTICA PLACE, SUITE 200
TULSA, OKLAHOMA 74114
[P] 918.744.4270 \ [F] 918.744.7849
WWW.KKTARCHITECTS.COM
C O F A # 534 6/30/25

PARK TOWER

7TH FLOOR

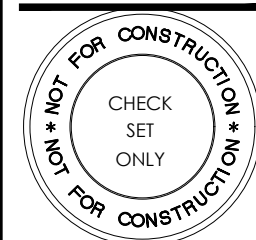


8.15.24

CFH

AS-BUILT
PLAN

AS-7

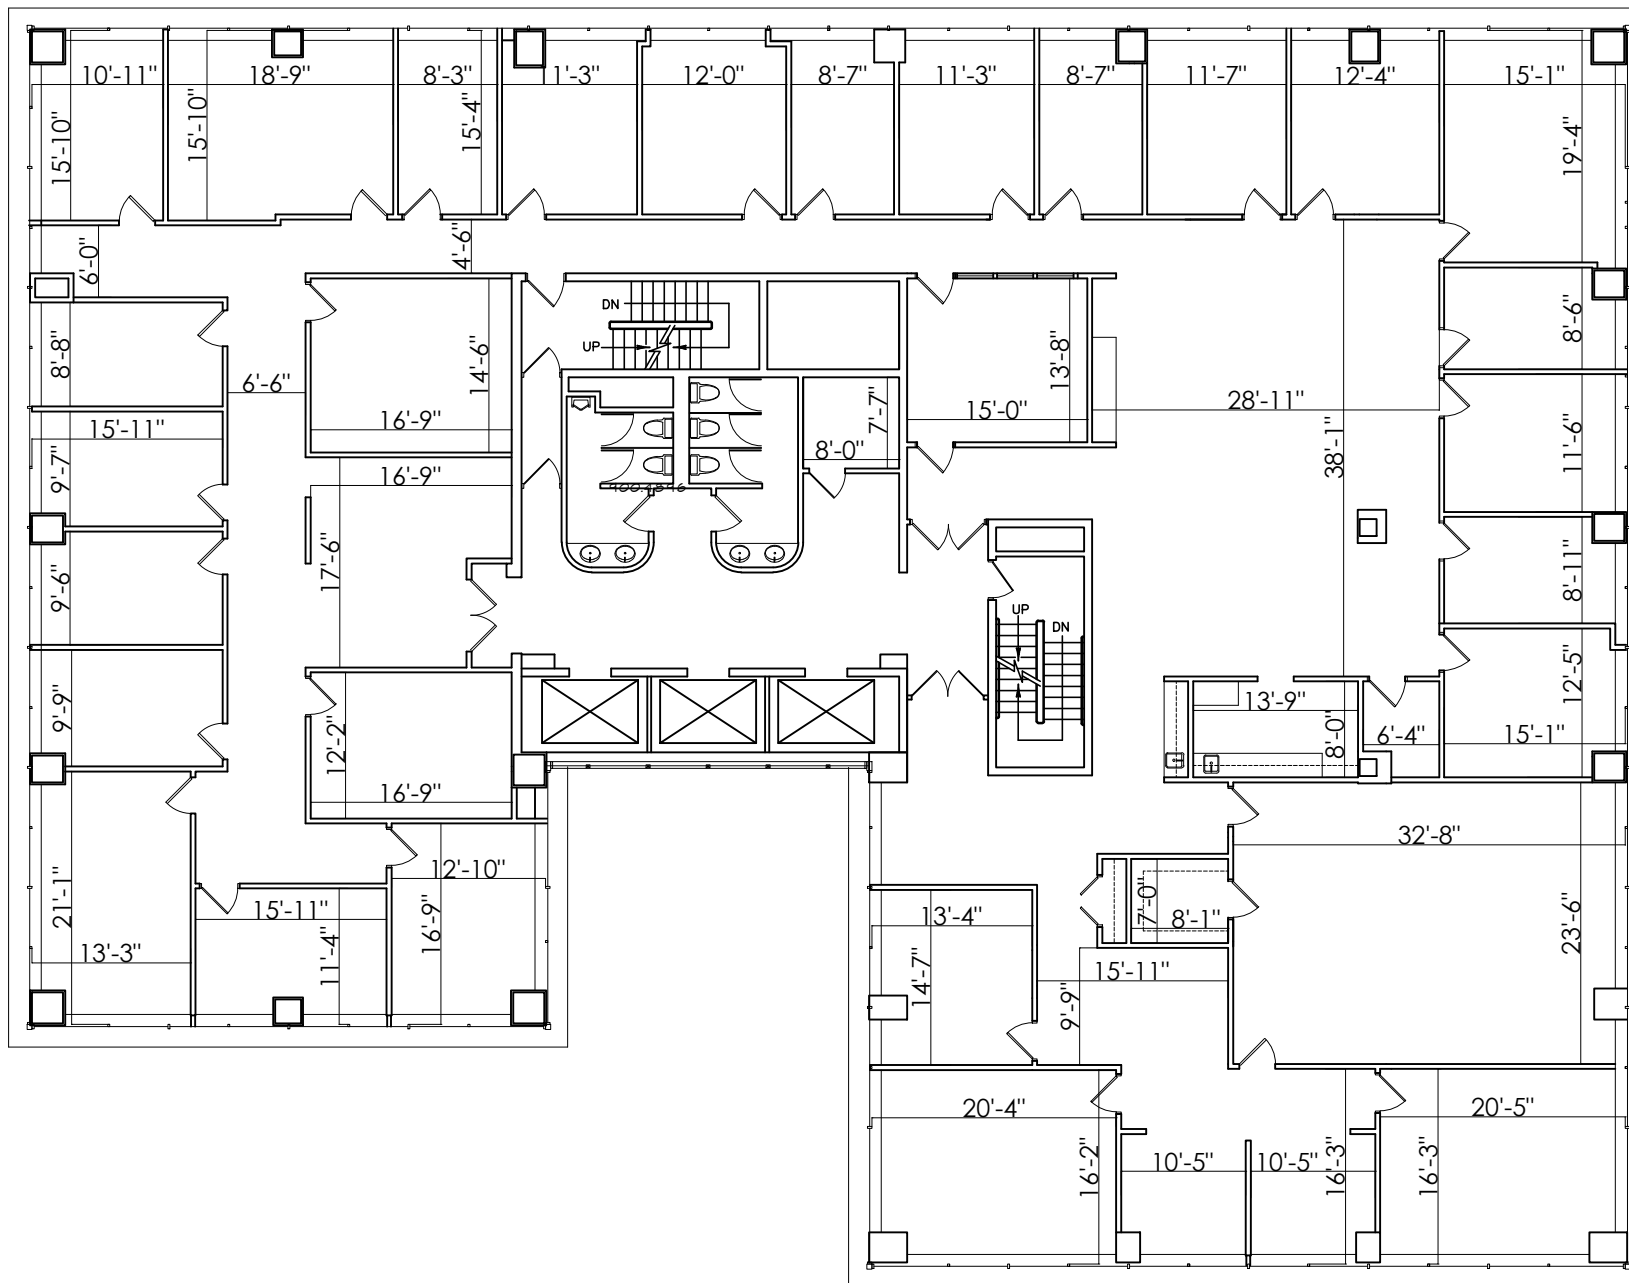

A FLOOR PLAN

SCALE: 1/16" = 1'-0"



NORTH

SUITE 700
12,356 RSF