


**A FLOOR PLAN**   
SCALE: N.T.S. NORTH

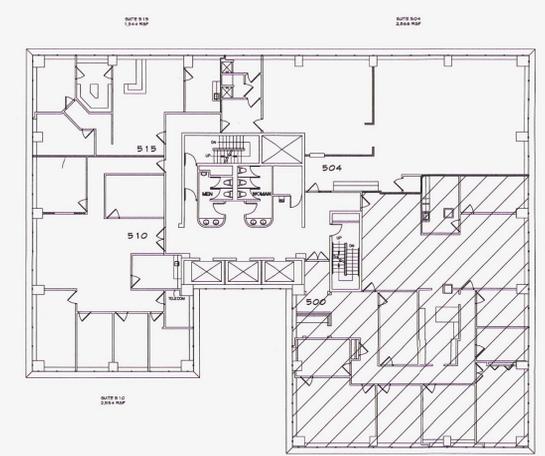

**A KEY PLAN**   
SCALE: N.T.S. NORTH

SUITE 500  
4,520.85 R.S.F.

**SUITE  
500**

PARK TOWER  
5TH FLOOR

CASE &  
ASSOCIATES

- 01.15.15 . . . . .
- 07.08.20 . . . . . JB - Pq.
- . . . . .
- . . . . .
- . . . . .
- . . . . .

AS-BUILT  
PLAN  
**AS.5**