




kinslow, keith & todd, inc.
architecture | interiors | engineering

tel 918.744.4270
fax 918.744.7849
2200 south ufica place, suite 200
tulsa, oklahoma 74114
www.kktarchitects.com

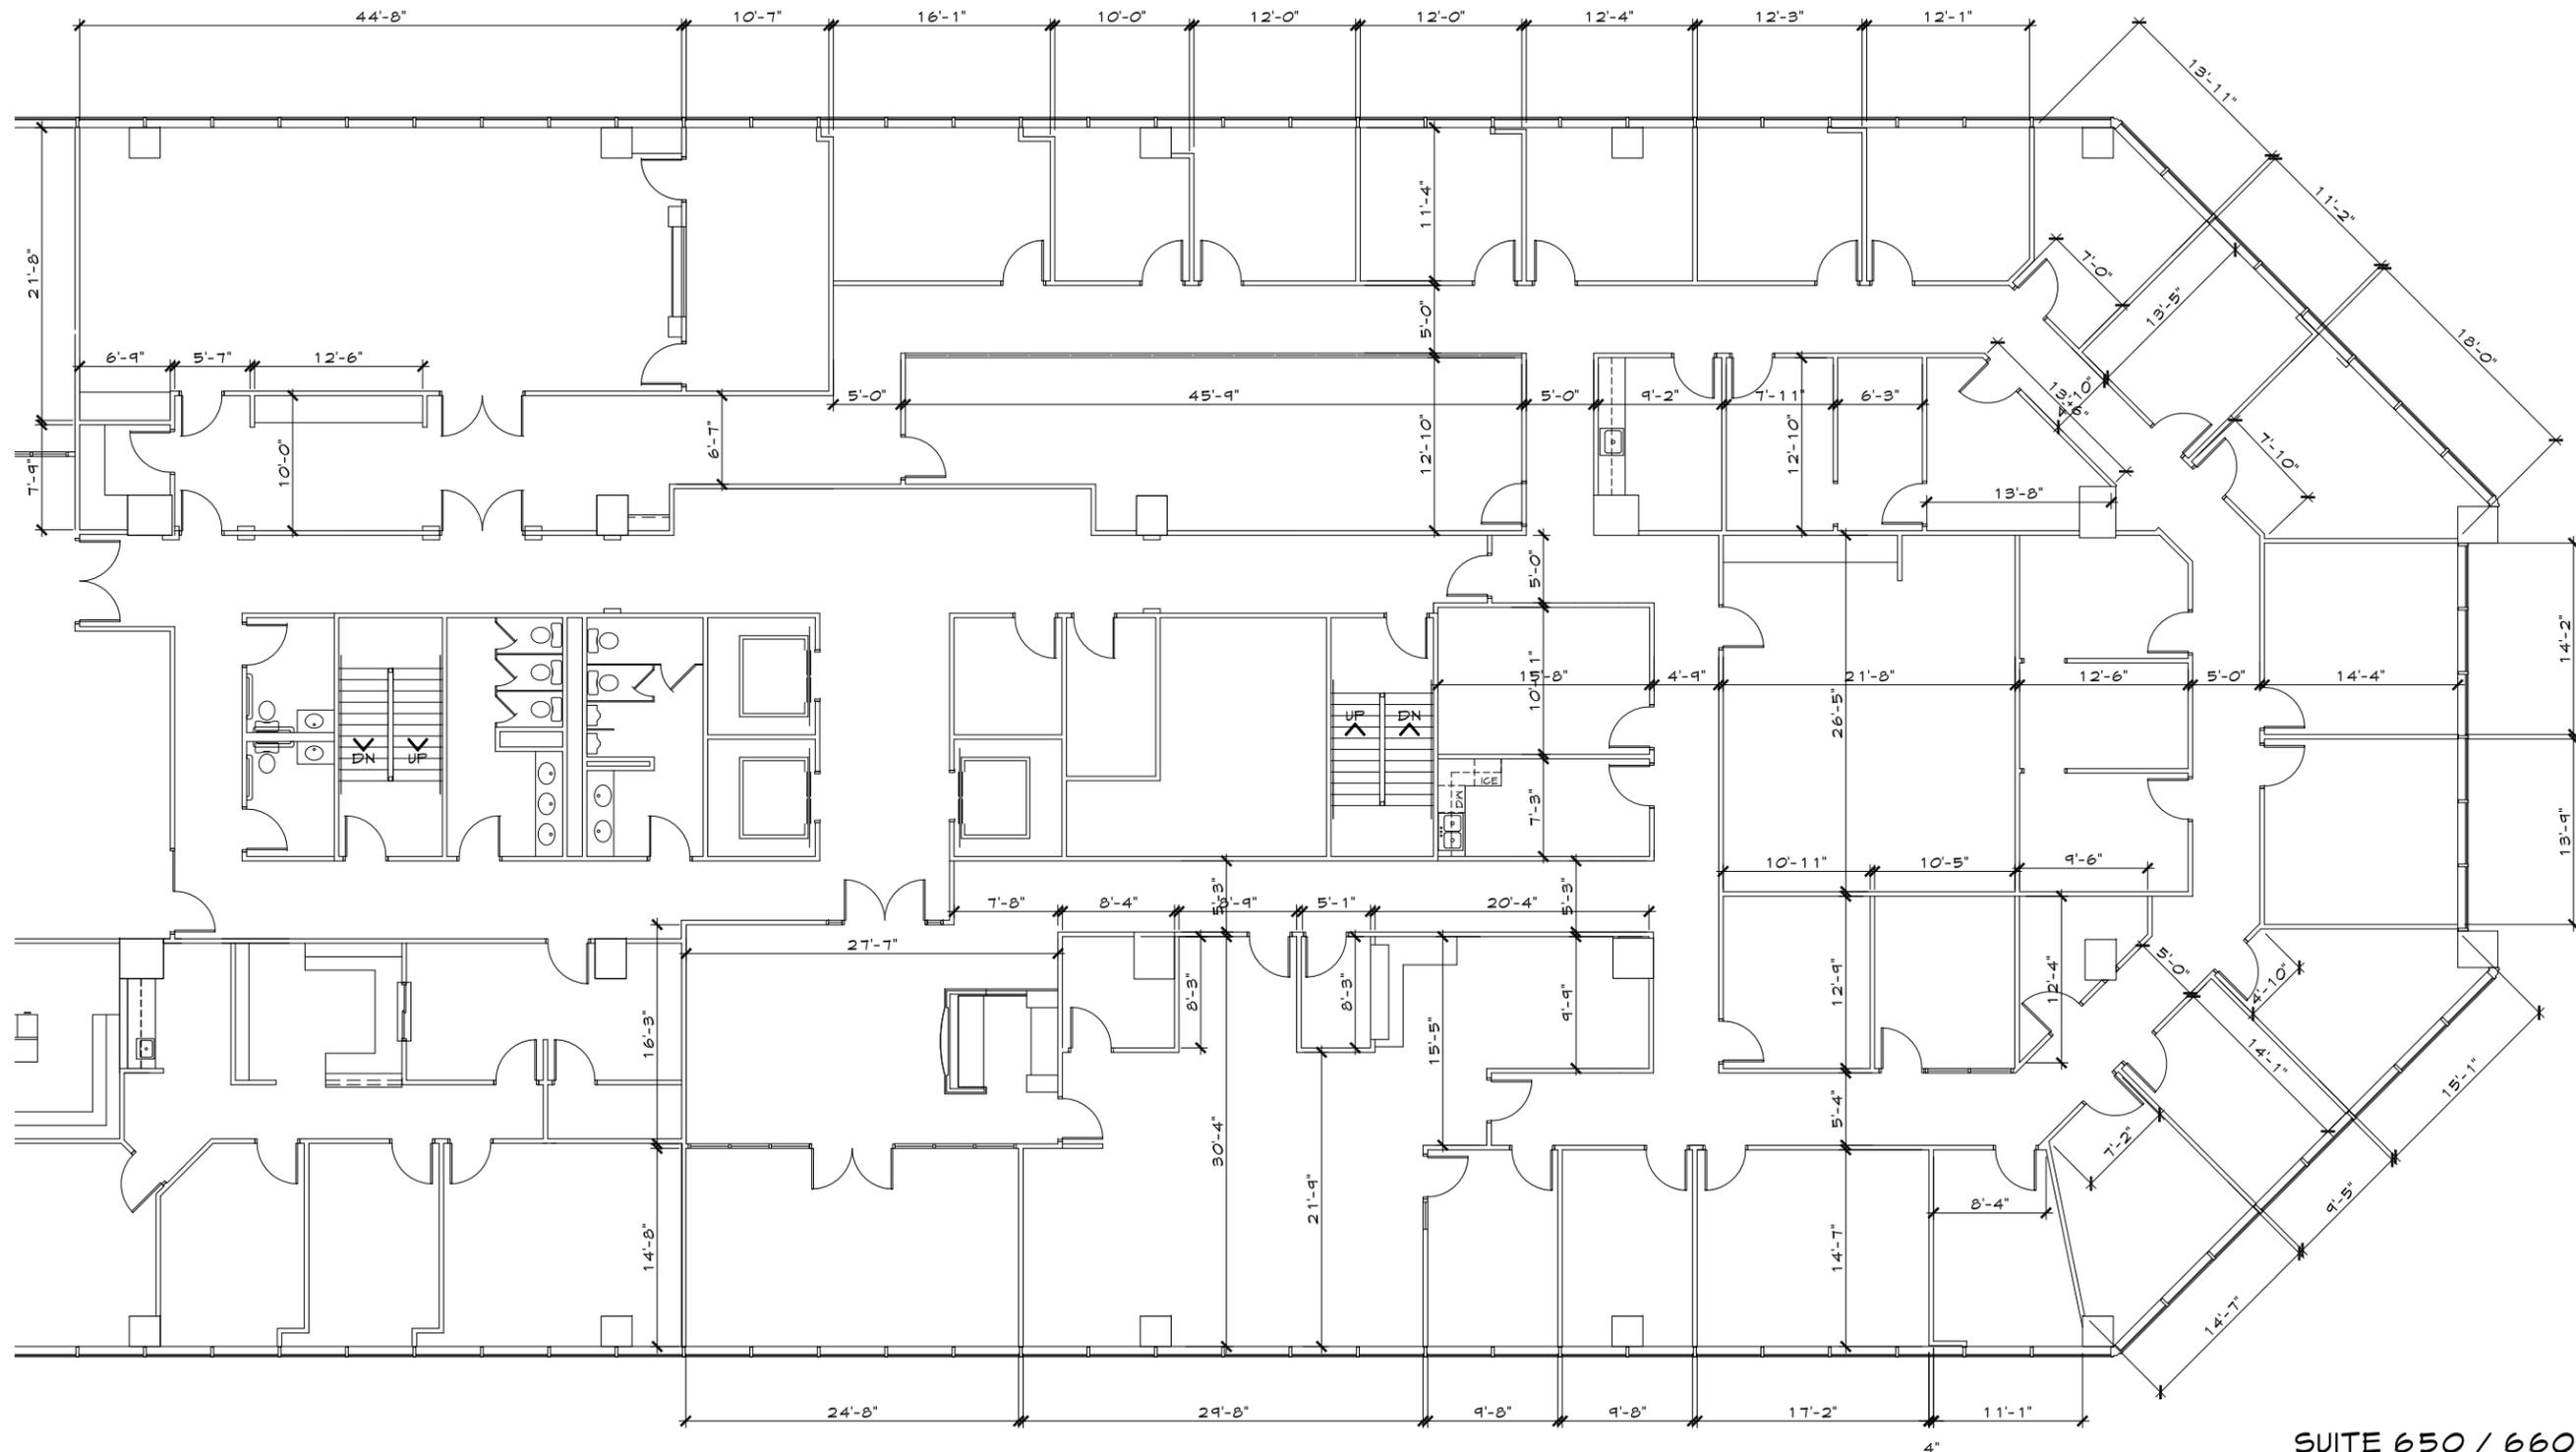

**SUITES
650/660**

SOUTHERN HILLS
TOWER
6TH FLOOR

CASE
& ASSOCIATES

SCALE	N.T.S.
FILE NAME	SHT06AS
MANAGER	ELS
DRAWN BY	ELS
08.30.11	

SUITE 650 / 660
NEW YORK LIFE
07-31-12
11190.97 USF
12757.71 RSF

AS-BUILT
PLAN

AS-6