


# B KEY PLAN

SCALE: N.T.S.



NORTH

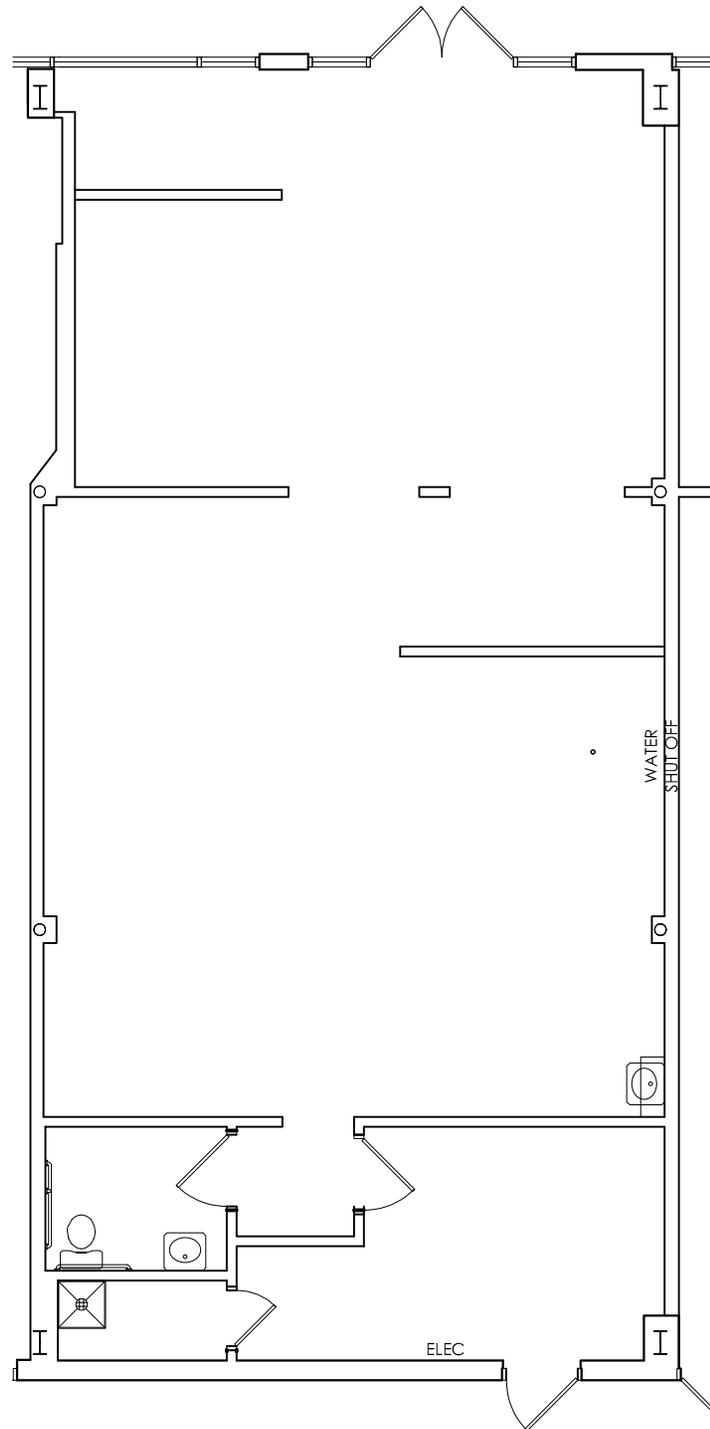

SUITE 105  
VACANT  
1609 RSF

# A FLOOR PLAN

SCALE: 1/8"=1'-0"



NORTH

# ETHOS ARCHITECTS

ETHOS ARCHITECTS, INC.  
2200 SOUTH UTICA PLACE, SUITE 200  
TULSA, OKLAHOMA 74114  
[ P ] 918.744.4270  
designETHOS.com

## SUITE 105

329 SOUTH  
ELM STREET  
JENKS, OK  
1ST FLOOR



AS-BUILT  
PLAN

## AS.1