

B KEY PLAN

SCALE: N.T.S.



NORTH


ETHOS ARCHITECTS

ETHOS ARCHITECTS, INC.
2200 SOUTH UTICA PLACE, SUITE 200
TULSA, OKLAHOMA 74114
[P] 918.744.4270
designETHOS.com

SUITE 207 2ND FLOOR

ELM STREET
MARKET
329 S. ELM ST.
JENKS, OK

CASE &
ASSOCIATES

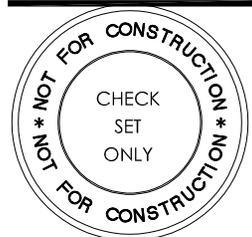


SUITE 207
VACANT
957 RSF

A FLOOR PLAN

SCALE: 3/16"=1'-0"



NORTH

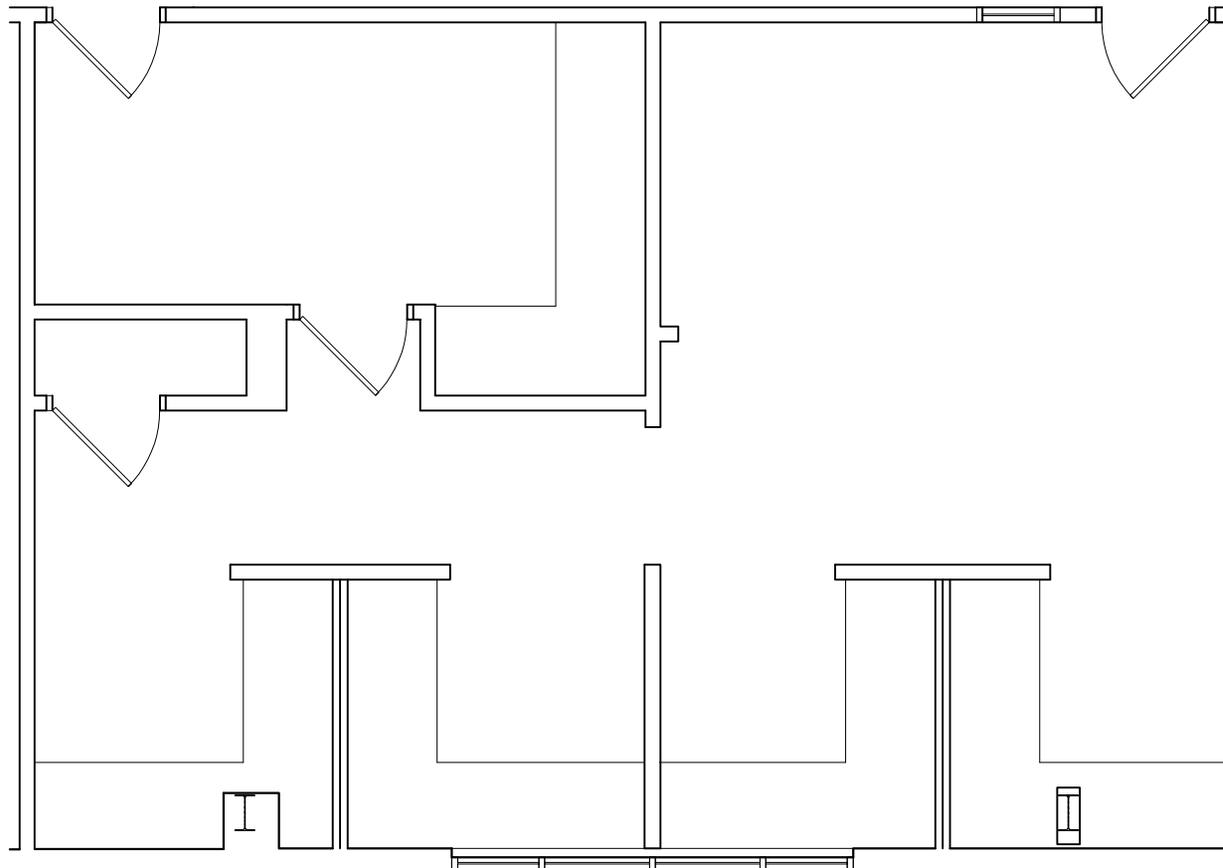

AS-BUILT
PLAN

AS.1