


B KEY PLAN 
 SCALE: N.T.S. NORTH

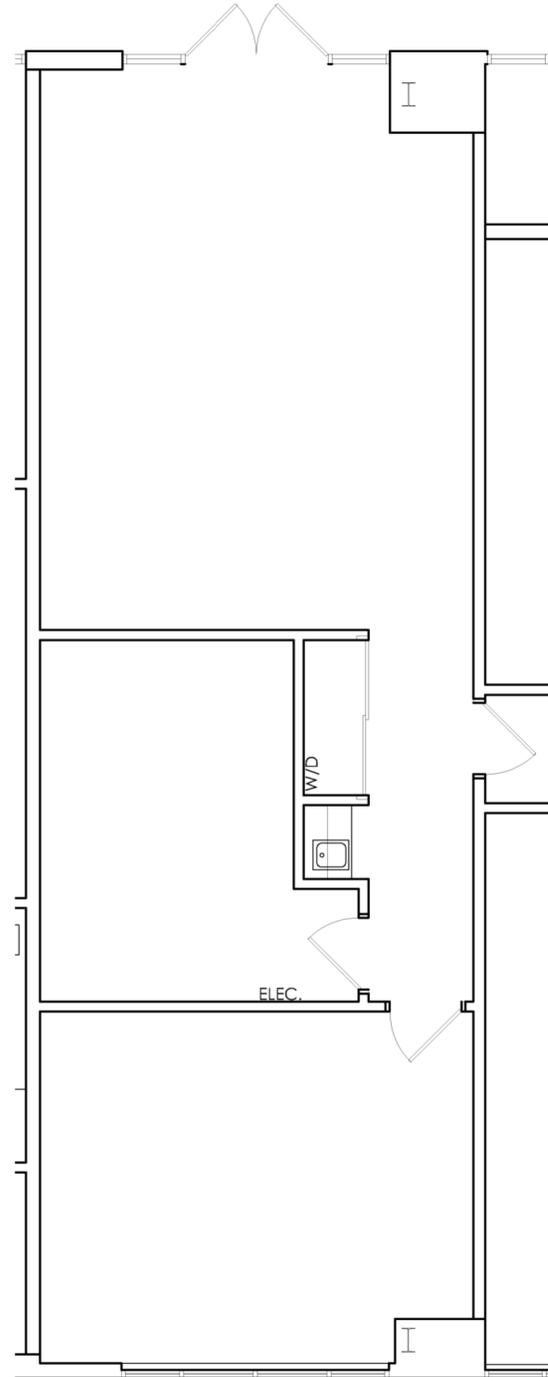

A FLOOR PLAN 
 SCALE: 1/8"=1'-0" NORTH

SUITE 230
 VACANT
 1245 RSF

ETHOS
 ARCHITECTS

ETHOS ARCHITECTS, INC.
 2200 SOUTH UTICA PLACE, SUITE 200
 TULSA, OKLAHOMA 74114
 [P] 918.744.4270
 designETHOS.com

**SUITE 230
 2ND FLOOR**

ELM STREET
 MARKET
 329 S. ELM ST.
 JENKS, OK

CASE &
 ASSOCIATES



AS-BUILT
 PLAN

AS.1